




ROOF PLAN
 UNIT 3 - TOTAL LIVING AREA - 104 ± SQ. FT.
 UNIT 3 - EXCLUSIVE USE ROOF AREA - 1113 ± SQ. FT.

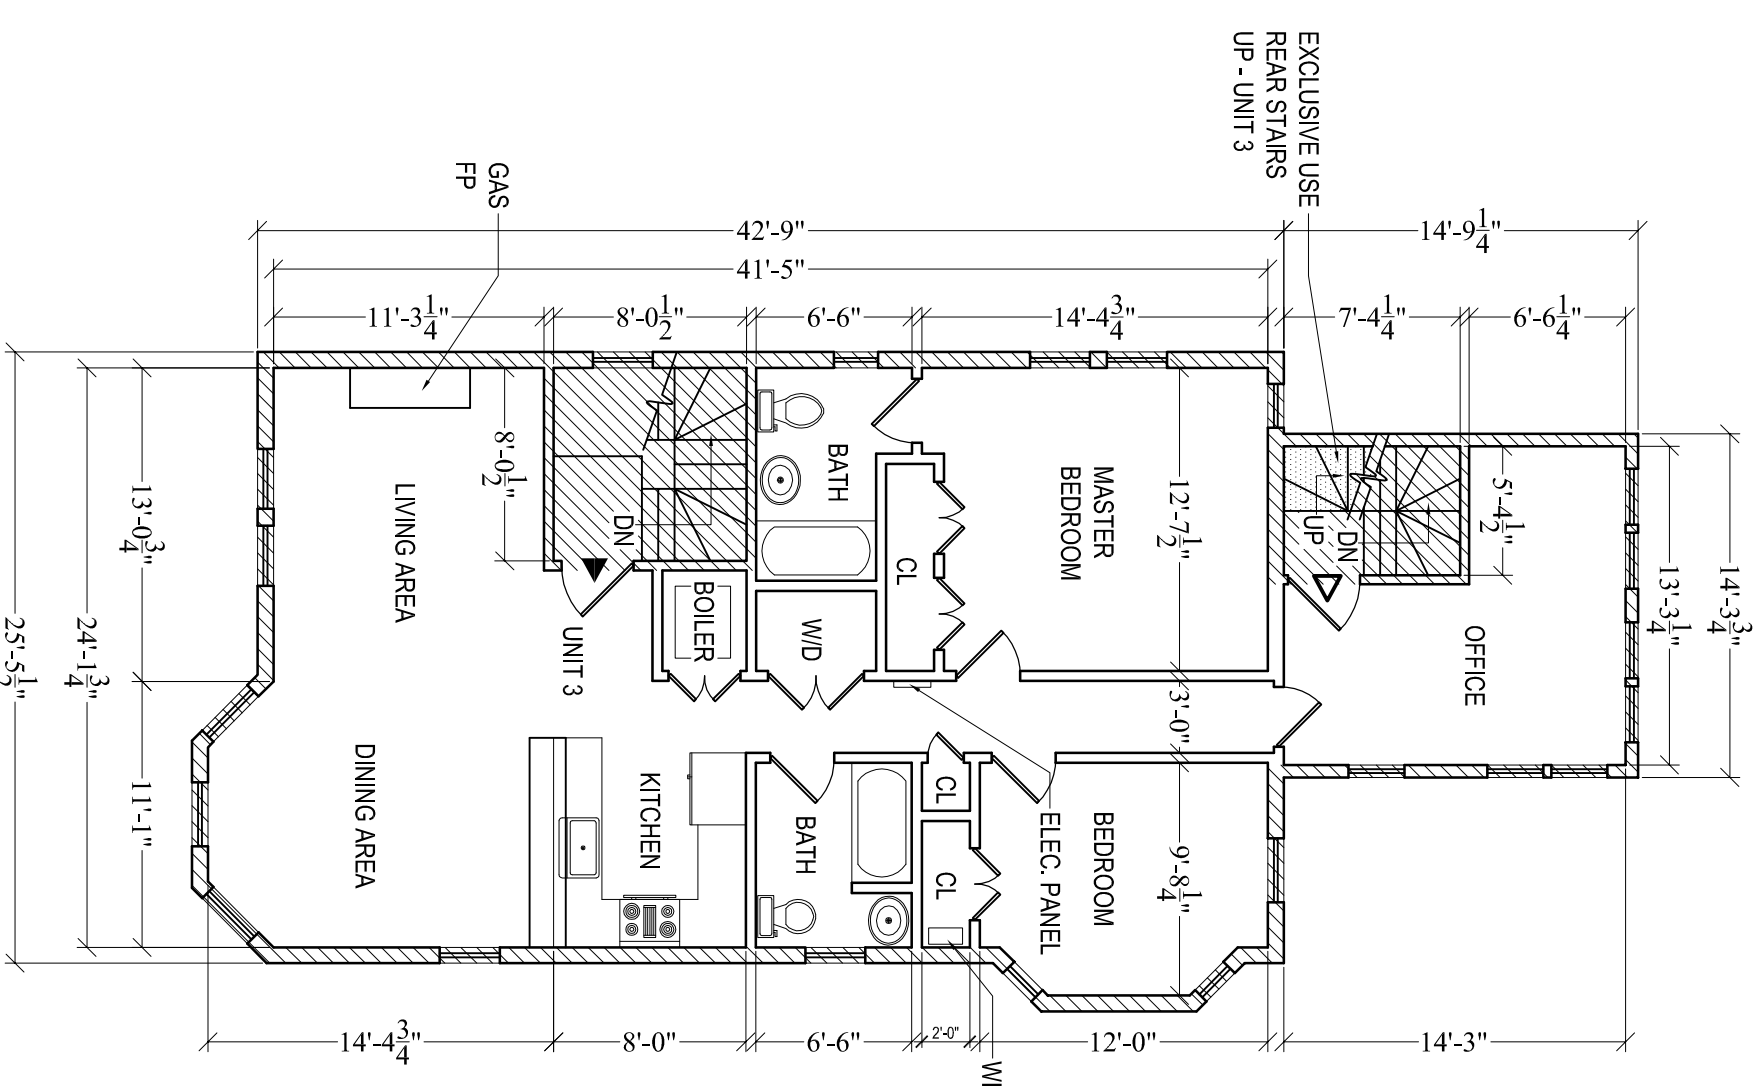


THIRD FLOOR PLAN
 UNIT 3 - TOTAL LIVING AREA - 1114 ± SQ. FT.

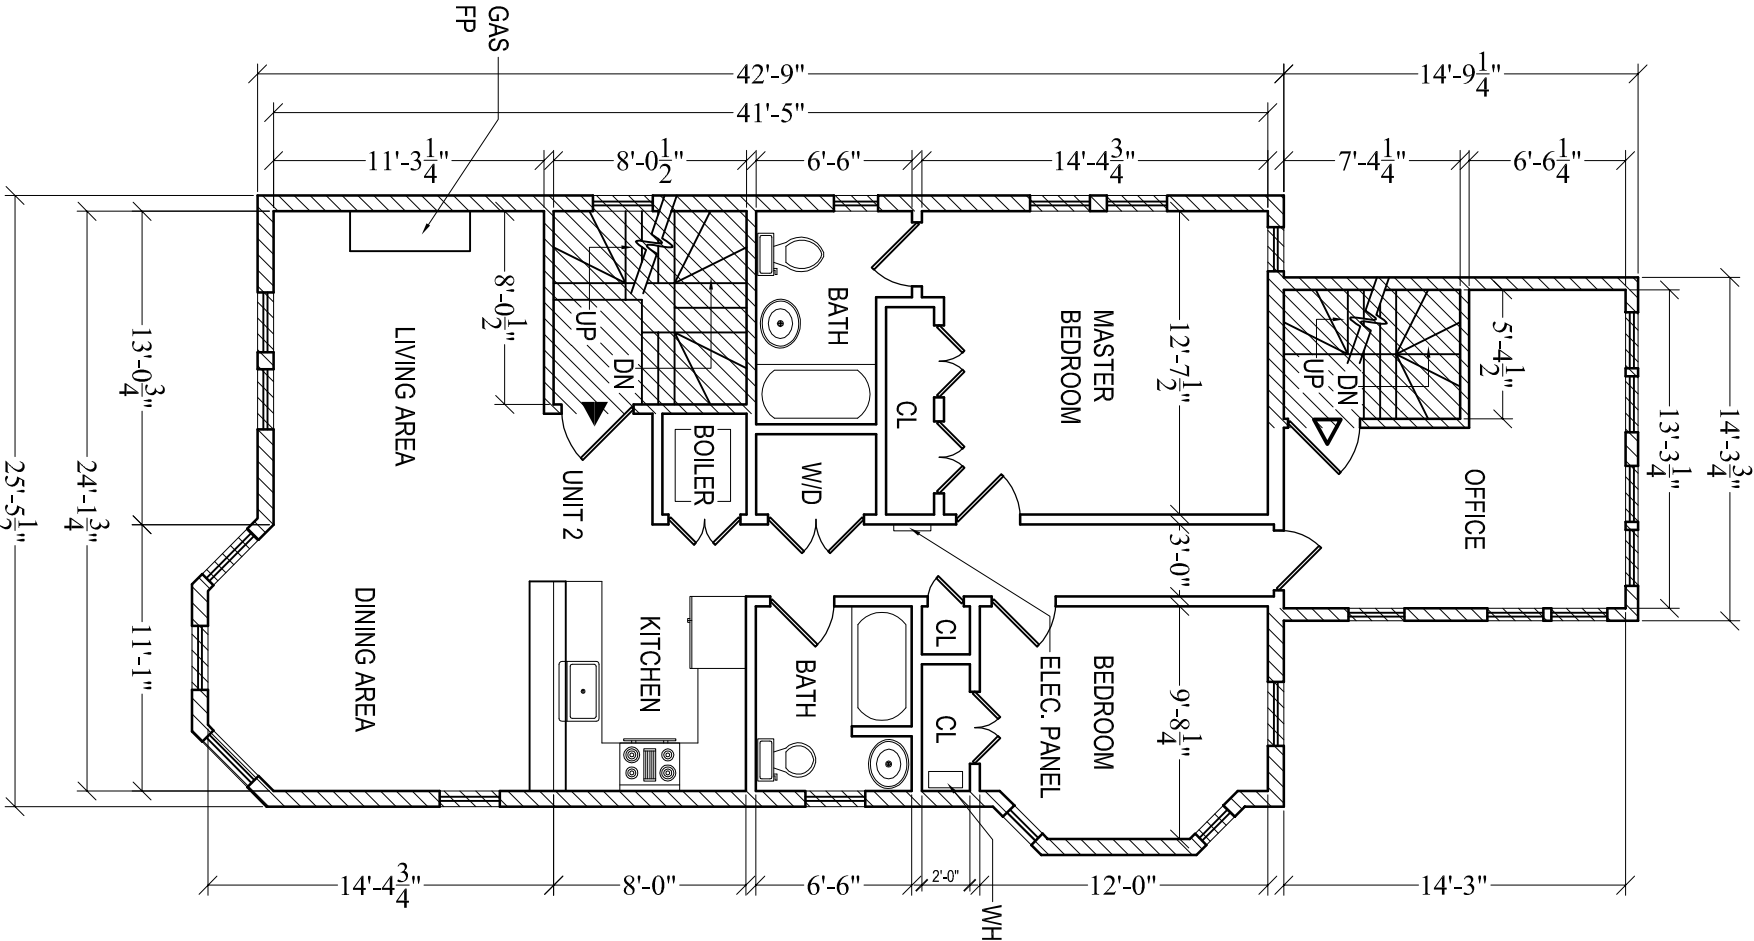

SECOND FLOOR PLAN
 UNIT 2 - TOTAL LIVING AREA - 1114 ± SQ. FT.

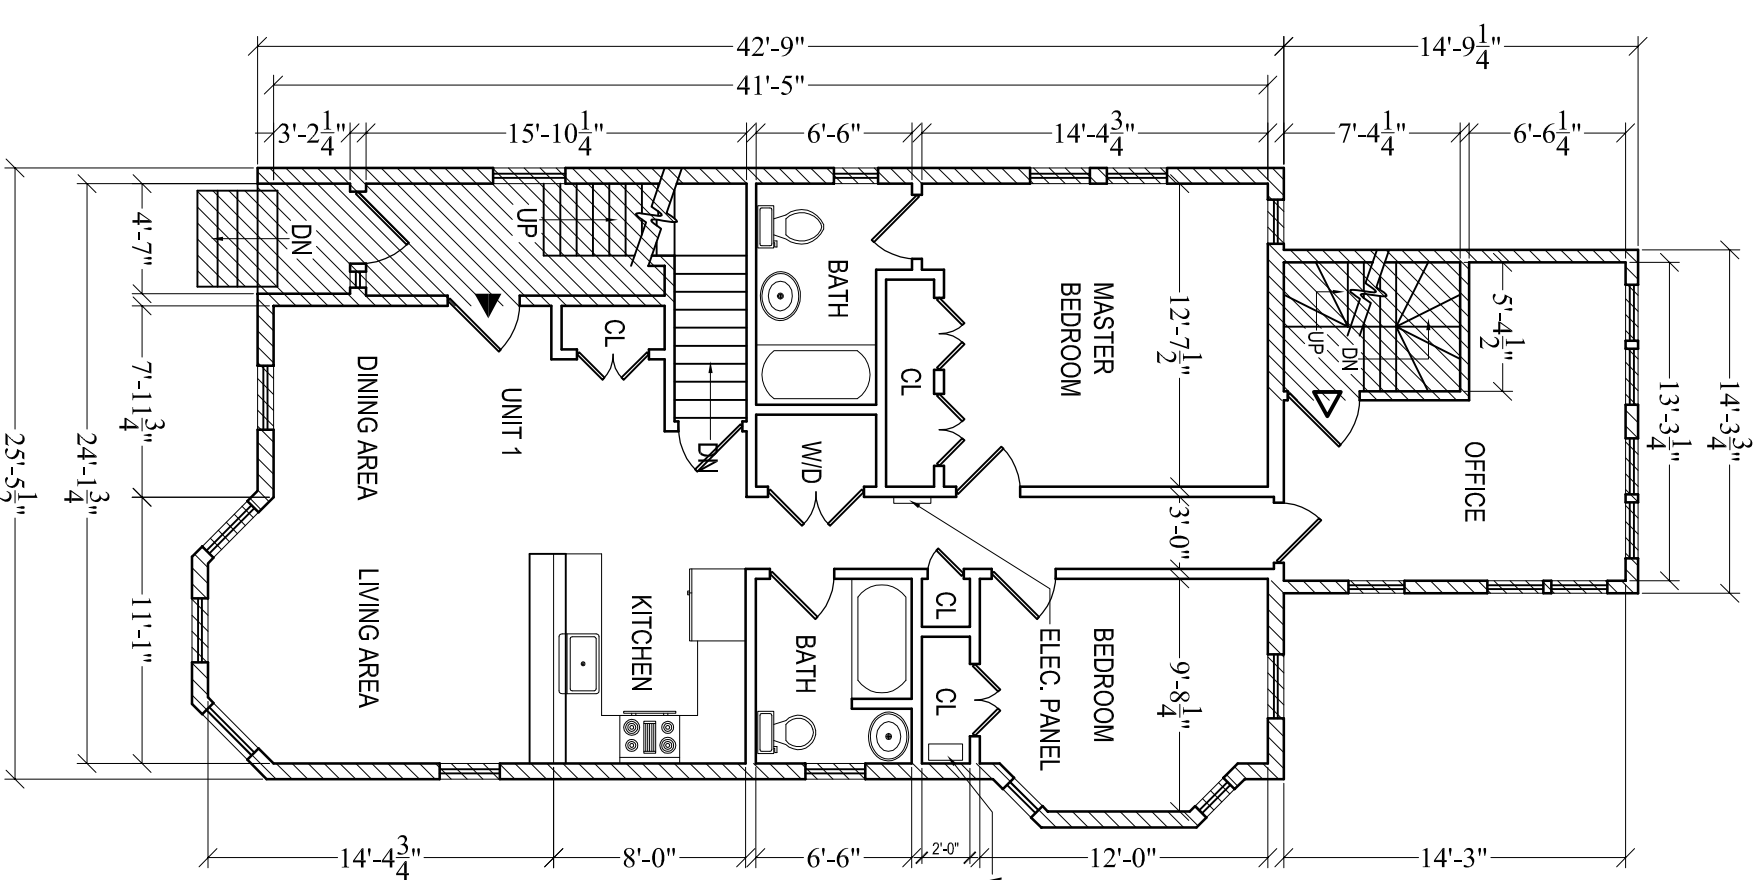


FIRST FLOOR PLAN
 UNIT 1 - TOTAL LIVING AREA - 1105 ± SQ. FT.

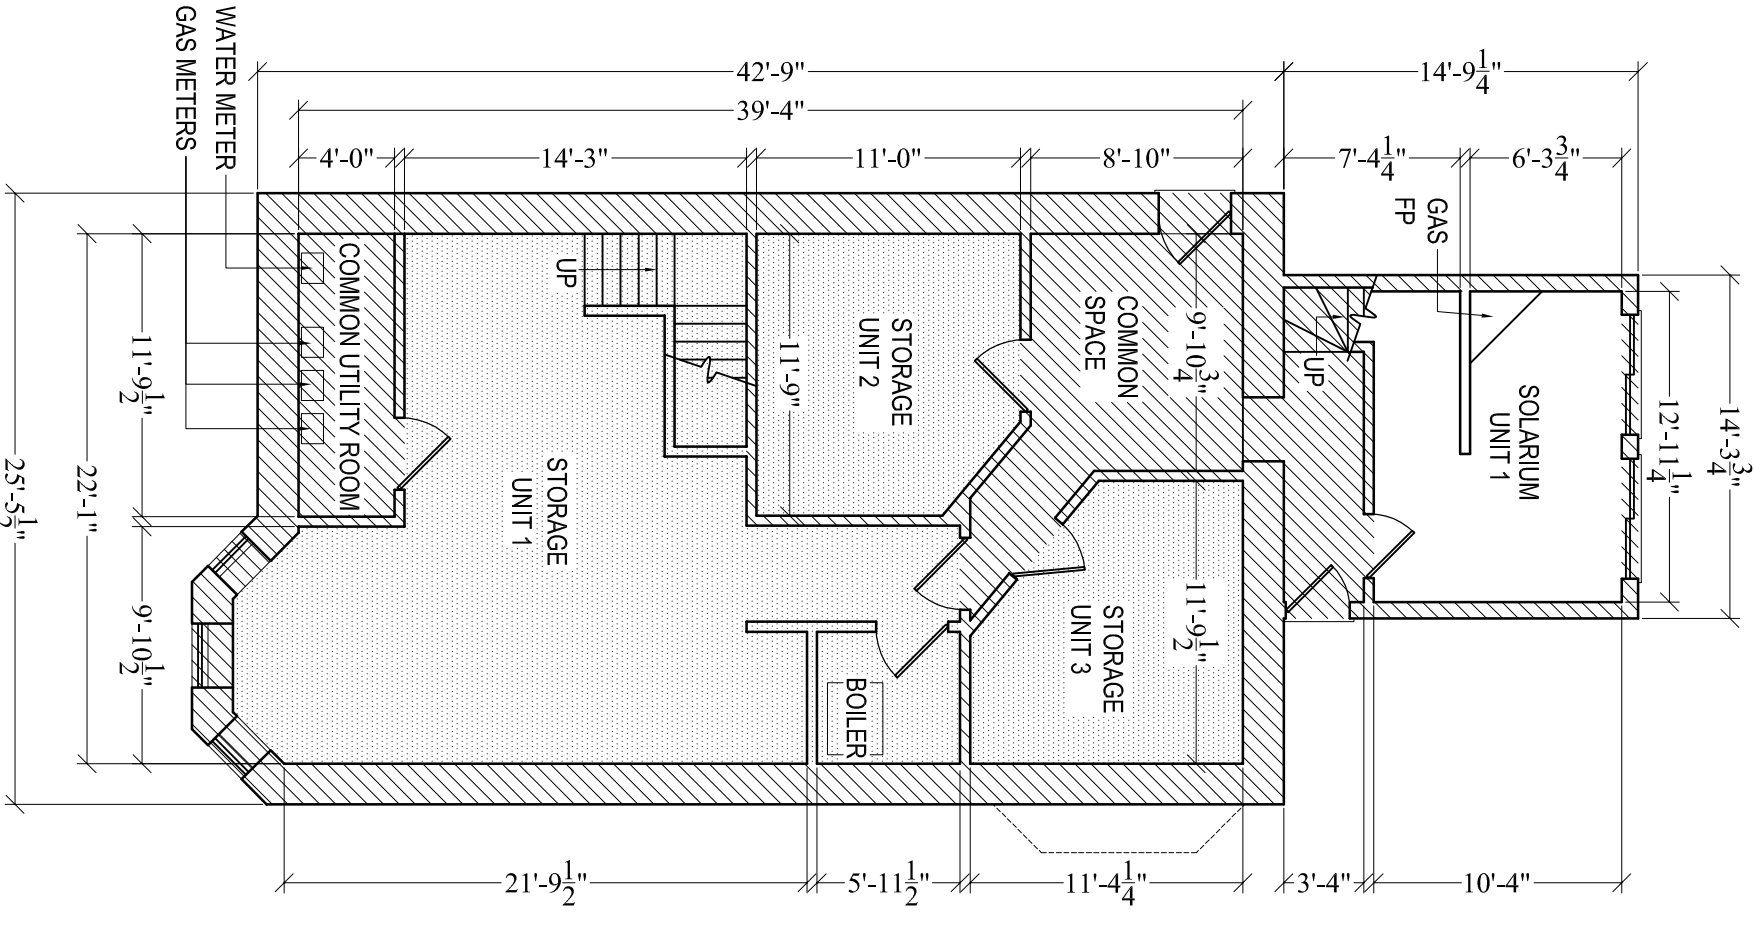

BASEMENT PLAN
 UNIT 1 - EXCLUSIVE USE STORAGE AREA - 467 ± SQ. FT.
 UNIT 1 - TOTAL SOLARIUM AREA - 135 ± SQ. FT.
 UNIT 2 - EXCLUSIVE USE STORAGE AREA - 123 ± SQ. FT.
 UNIT 3 - EXCLUSIVE USE STORAGE AREA - 117 ± SQ. FT.

- ▲ INDICATES PRIMARY UNIT ENTRANCE
 - ▽ INDICATES SECONDARY UNIT ENTRANCE
 - ▨ INDICATES COMMON AREA
 - ▤ INDICATES EXCLUSIVE USE COMMON AREA
- REGISTRY USE ONLY**

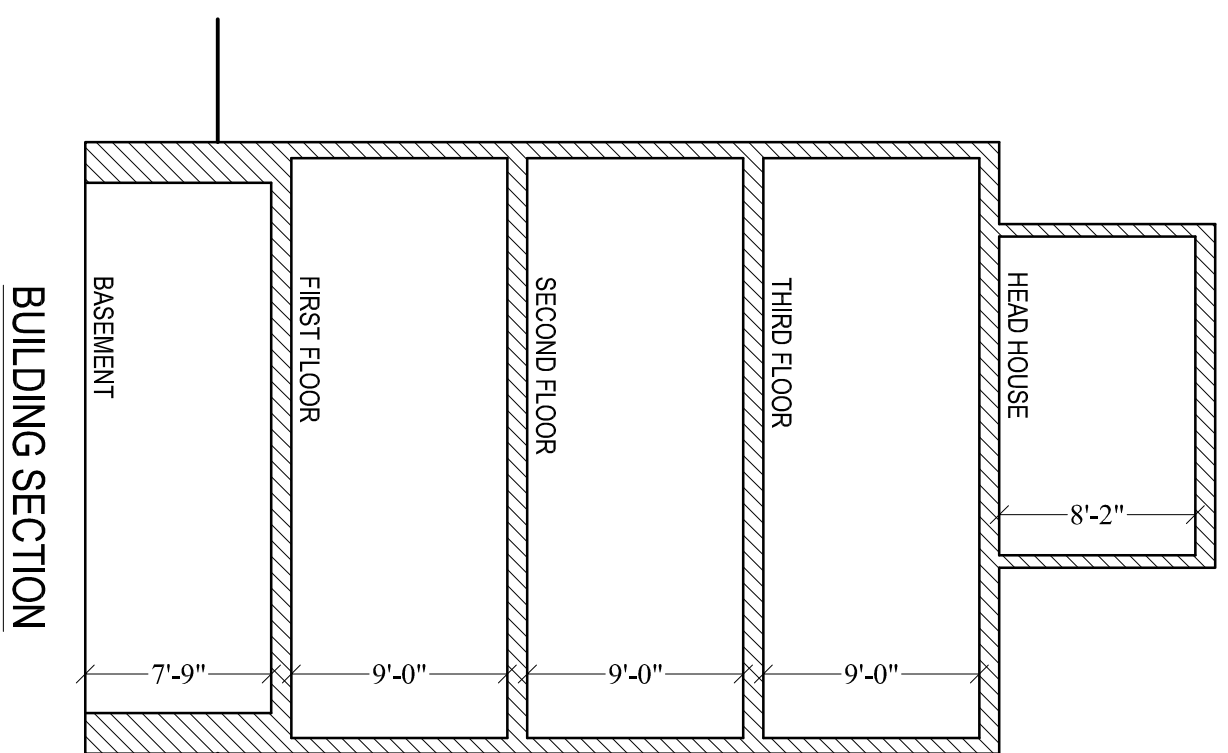

BUILDING SECTION

TOTAL DEDICATED UNIT SQUARE FOOTAGE	
UNIT 1	EXCLUSIVE USE BASEMENT STORAGE AREA
UNIT 1	BASEMENT SOLARIUM AREA
UNIT 1	FIRST FLOOR LIVING AREA
UNIT 1	TOTAL LIVING AREA
UNIT 2	SECOND FLOOR LIVING AREA
UNIT 2	EXCLUSIVE USE BASEMENT STORAGE AREA
UNIT 2	TOTAL LIVING AREA
UNIT 3	THIRD FLOOR LIVING AREA
UNIT 3	HEAD HOUSE LIVING AREA
UNIT 3	EXCLUSIVE USE ROOF AREA
UNIT 3	EXCLUSIVE USE BASEMENT STORAGE AREA
UNIT 3	TOTAL LIVING AREA

15 HOWELL STREET CONDOMINIUM

NOTE: THIS SITE PLAN WAS NOT MADE FROM AN INSTRUMENT SURVEY AND IT IS NOT TO BE USED FOR ESTABLISHMENT OF PROPERTY LINES, FENCES, PLANTINGS, ETC., OR THE CONSTRUCTION OF ADDITIONAL STRUCTURES. THIS CERTIFICATION IS BASED UPON THE LEGAL DESCRIPTION(S) OF THE PREMISES SHOWN HEREON WHICH WERE PROVIDED BY THE CLIENT. TOWN, TAX MAPS, LINES OF OCCUPATION AND DOES NOT PURPORT TO REVEAL ANY INCONSISTENCIES AND/OR ENCROACHMENTS WHICH MAY BE DISCOVERED WITH A FULL AND COMPLETE TITLE SEARCH, EXAMINATION OF RECORDS AND/OR INSTRUMENT SURVEY. NO CERTIFICATION IS HEREBY MADE WITH RESPECT TO ANY OTHER PROVISIONS OF SAID PLAN.

SITE DATA SHOWN ON THIS PLAN WAS PREPARED BY:
 SNEILING & HALE, ASSOCIATES, INC., PROFESSIONAL LAND SURVEYORS
 LONDON, MA 01773TEL: 617-262-1313; FAX: 617-262-1616
 DATED: 06-26-10

NOTE:
 DIMENSIONS SHOWN ARE TAKEN FROM
 FACE OF WALL TO FACE OF WALL.

FOR CLIENT REVIEW

**15 HOWELL STREET
 CONDOMINIUM
 15 HOWELL STREET
 BOSTON, MASSACHUSETTS
 (DORCHESTER DISTRICT)**

I HEREBY CERTIFY THAT THIS PLAN FULLY AND ACCURATELY DEPICTS THE LAYOUT, LOCATION, UNIT NUMBER AND DIMENSIONS OF THE UNITS AS BUILT. I FURTHER CERTIFY THAT THIS PLAN HAS BEEN PREPARED IN CONFORMITY WITH THE RULES AND REGULATIONS OF THE REGISTERS OF DEEDS OF THE COMMONWEALTH OF MASSACHUSETTS.

WILLIAM P. CHRISTOPHER, ARCHITECT

**ROCHE - CHRISTOPHER
 ARCHITECTURE, LLC**
 www.roche-christopher.com

415 Neponset Ave.
 Dorchester, Massachusetts 02122

Telephone: 617-282-0030
 Fax: 617-292-1080

DATE: **FEBRUARY 15, 2011**
 SCALE: **1/8"=1'-0"**

GRAPHIC SCALE:
 0 5 10 20